

Beautiful 3-room apartment transformed into a large 2-room apartment

For sale

Sole agent

Price on request


<i>Product type</i> Apartment	<i>Num rooms</i> 3 rooms	<i>Building</i> Villa Bellevue (Plati)	<i>District</i> Jardin Exotique
<i>Living area</i> 46 m²	<i>Terrace area</i> 13 m²	<i>Total area</i> 59 m²	<i>Bedrooms</i> 2
<i>Bathroom</i> 1	<i>Floor</i> Ground floor	<i>Condition</i> Good condition	<i>Laws</i> Loi 1291
<i>Ref.</i> AD - 3 villa Bellevue Plati			


Beautiful apartment with views of the Palace and the sea in the "Plati" neighborhood

The apartment has been renovated and transformed into a large 2 pièces overlooking beautiful terrace of 13 m²

The apartment is under law 1291



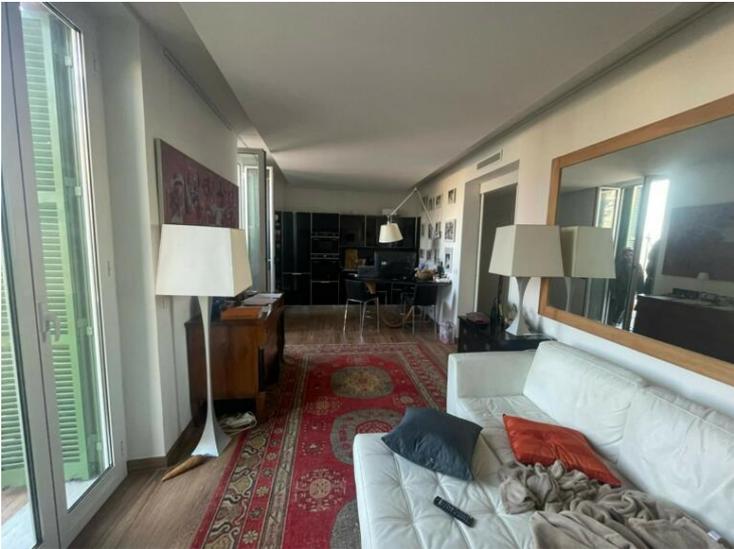

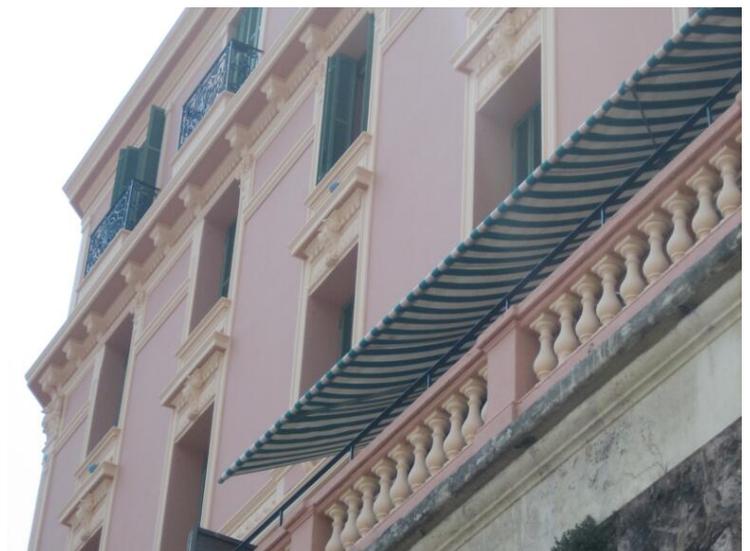

Plan de Recolement échelle 1/50°

